

~~SECRET-CONTROL/US OFFICIALS ONLY~~

25X1

1/Annex

25X1

Legend


- A Luftnachrichtenschule
- B Airfield
- C Fliegerhorst
- D Officers' billets
- E Plateau in Doelauer Heide
- F Telephone exchange
- G Doelauer Heide
 - 1 One double line (heavy field wire)
 - 2 Two double lines (heavy field wire)
 - 3 Seven double lines (heavy field wire)
 - 4 Two double lines and one single line (heavy field wire)
 - 5 Three field trunk lines
 - 6 Eight double lines (heavy field wire)
 - 7 22 lines of uninsulated wire
 - 8 22 lines of uninsulated wire
 - 9 Field trunk lines
 - 10 Field trunk lines
 - 11 Three double lines (heavy field wire)
 - 12 Double line (heavy field wire)
 - 13 Power line.

~~SECRET-CONTROL/US OFFICIALS ONLY~~

SECRET CONTROL/US OFFICIALS ONLY

LETTIN

Legend: See report.

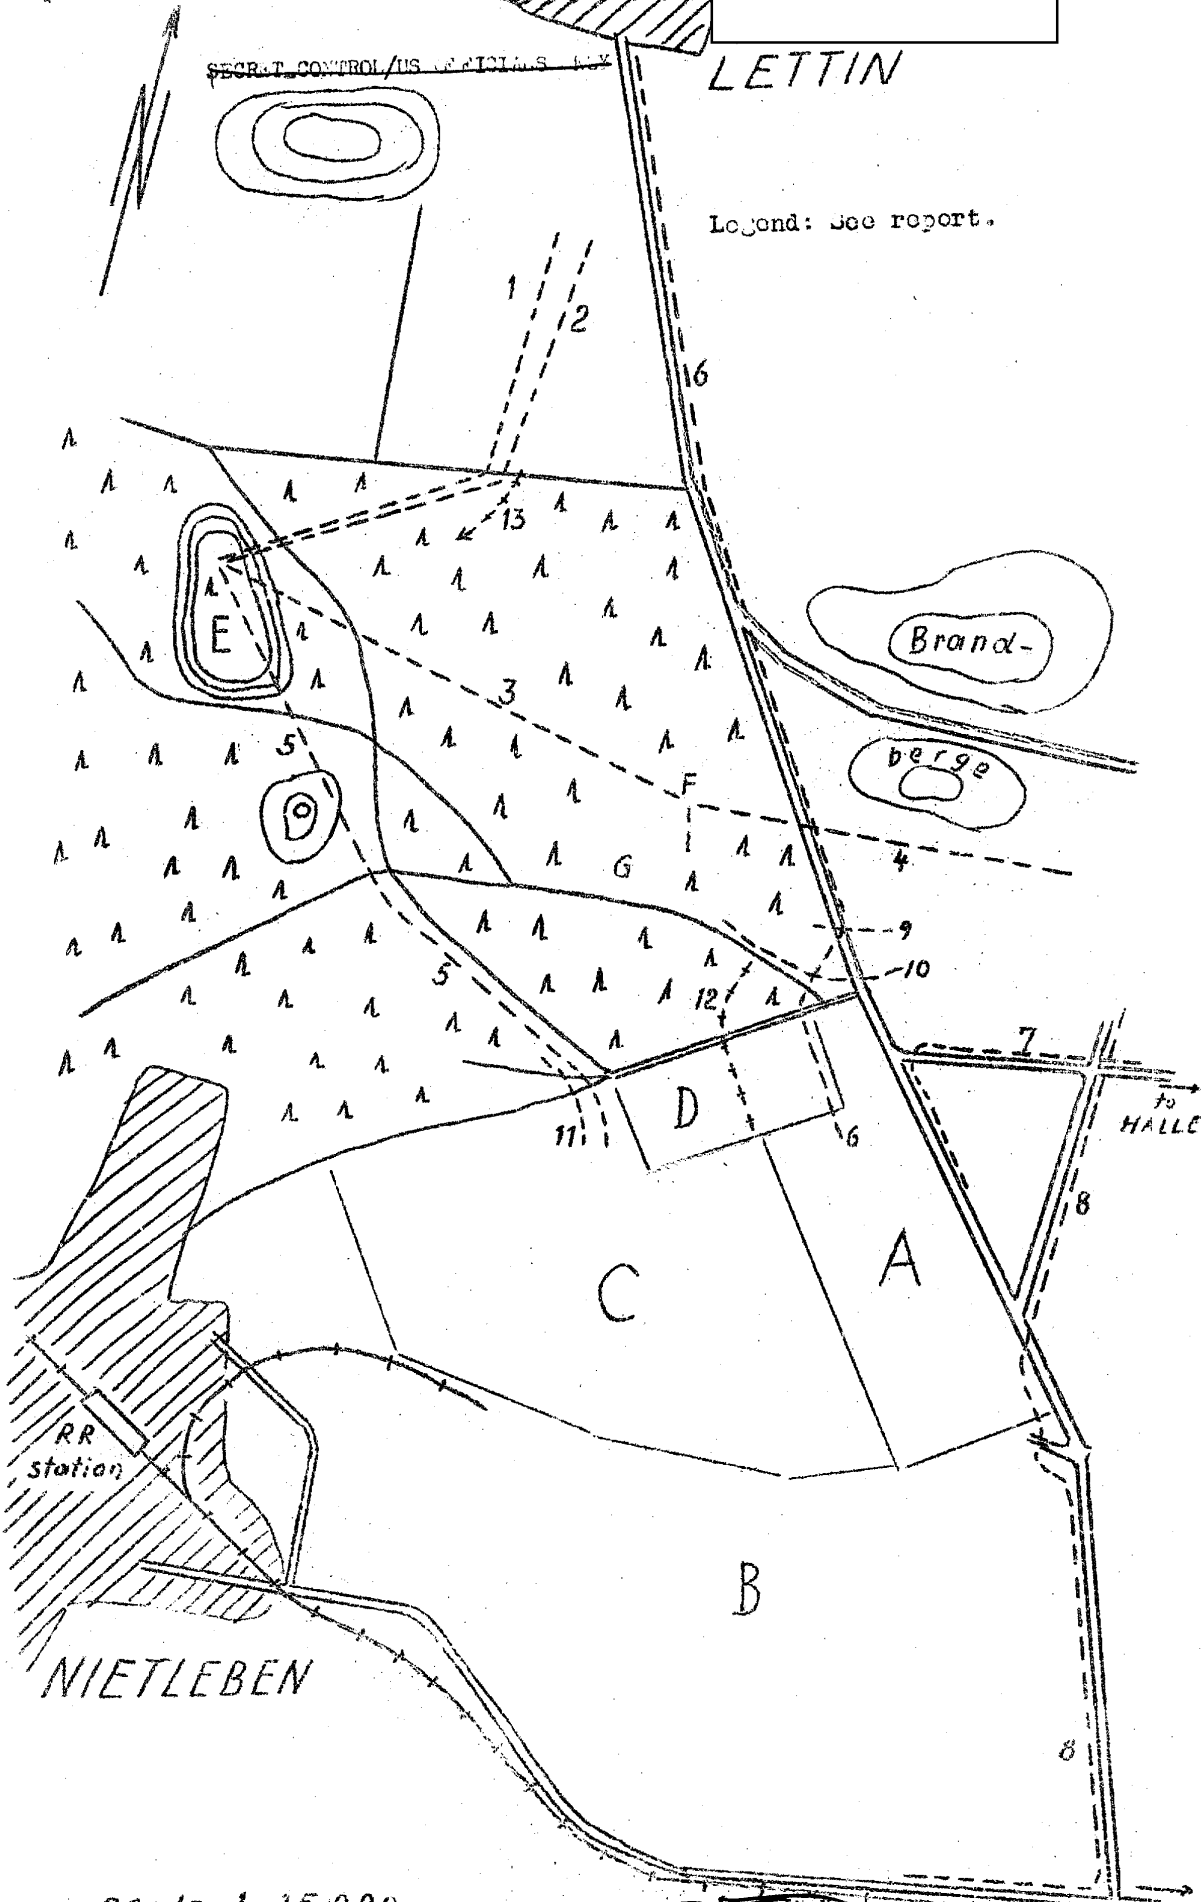

scale 1:15,000